

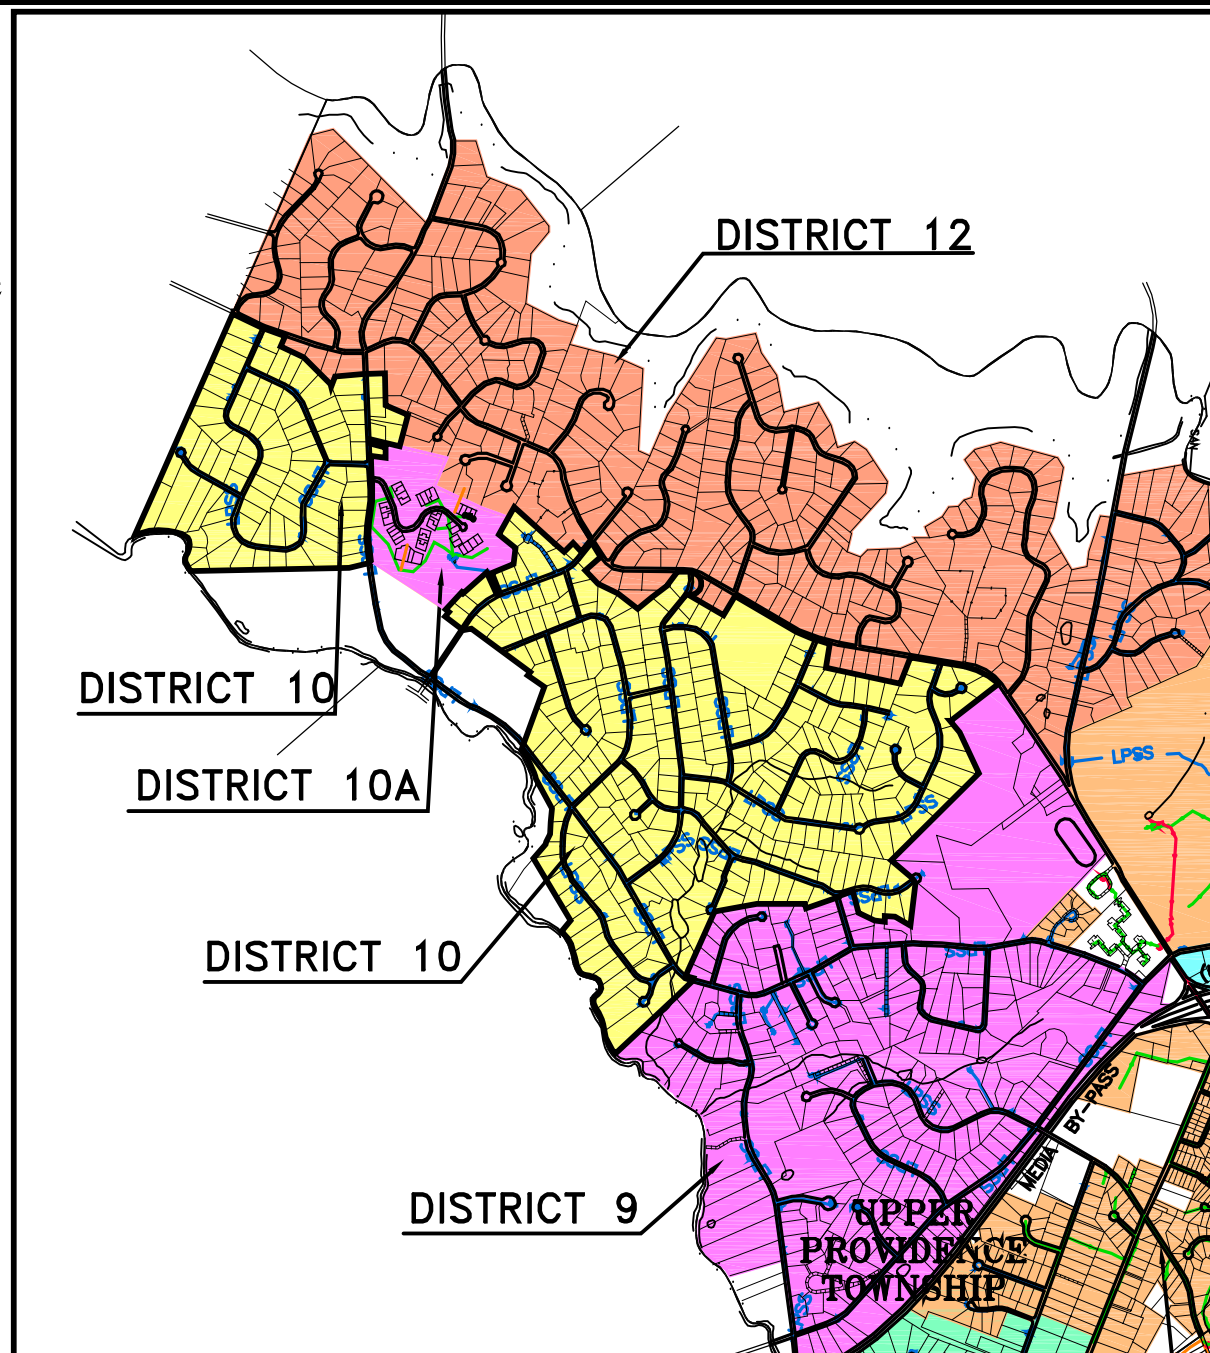
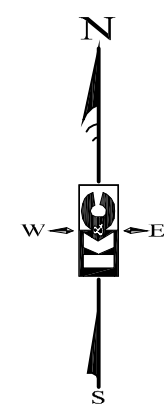
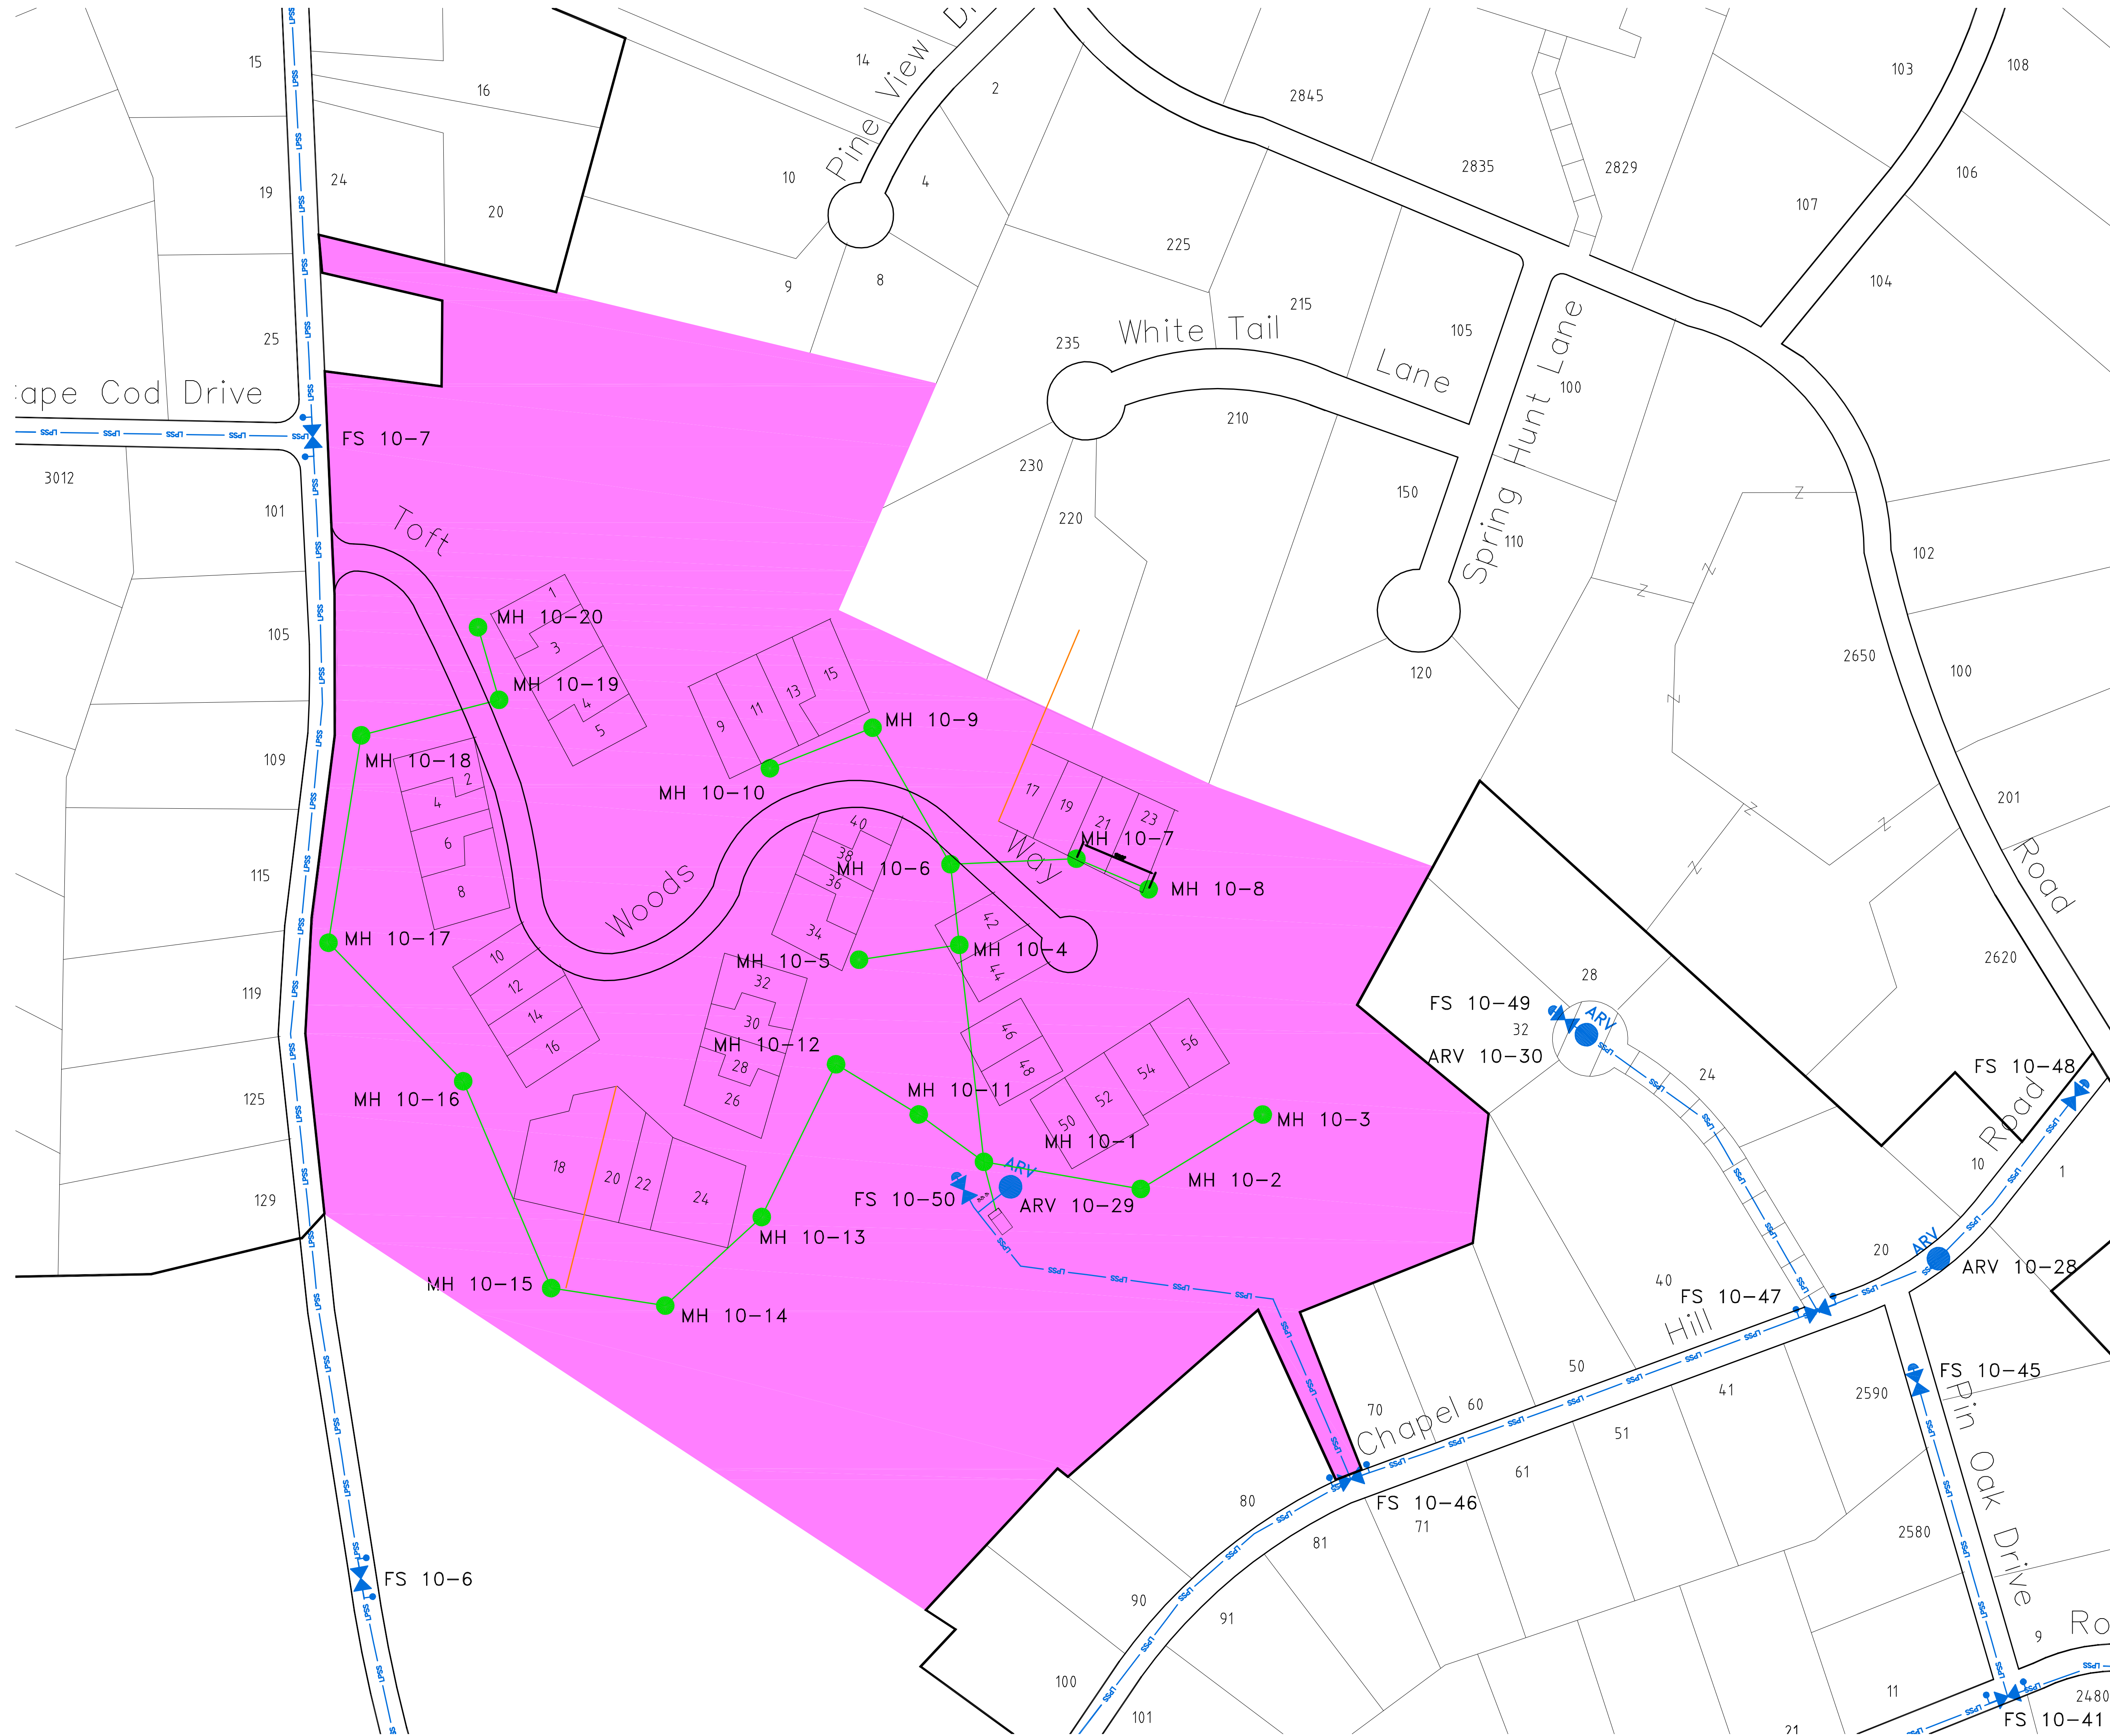


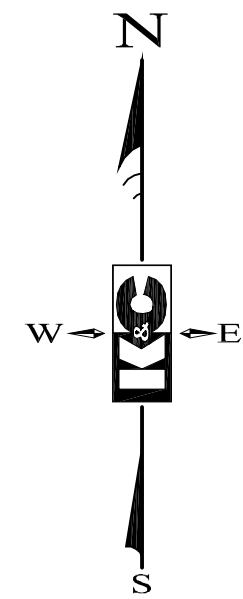

LEGEND	
	SANITARY SEWER and MANHOLE
	SANITARY FORCE MAIN and PUMP STATION
	SANITARY FORCE MAIN and GRINDER PUMP
	SAN. FORCE MAIN M.H. (WASHOUT or AIR RELIEF)
	LOW PRESSURE SEWER SYSTEM (LPSS)
	END-LINE FLUSHING STATION
	IN-LINE FLUSHING STATION
	AIR RELEASE VALVE
	UNIVERSAL AIR RELEASE VALVE
	SANITARY SEWER and MANHOLE OWNED BY AQUA (MEDIA)
	DISTRICT 1 - LEMON STREET PUMP STATION
	DISTRICT 2 - VALLEY VIEW PUMP STATION
	DISTRICT 3 - WINTER STREET PUMP STATION
	DISTRICT 4 - BRAVES TRAIL PUMP STATION
	DISTRICT 5 - MEDIA STATION PUMP STATION
	DISTRICT 6 - BORTONDALE PUMP STATION
	DISTRICT 7 - WOODED WAY LOW PRESSURE SYSTEM
	DISTRICT 8 - CDCA / FARNUM ROAD
	DISTRICT 9 - RIDLEY CREEK LPSS - SOUTH
	DISTRICT 10 - RIDLEY CREEK LPSS - NORTH
	DISTRICT 10A - TOFT WOODS WAY - NORTH
	DISTRICT 11 - CRUM CREEK LPSS - SOUTH
	DISTRICT 12 - CRUM CREEK LPSS - NORTH
	UPTSA CONNECTIONS BYPASSING THE SEWER METER
	PRIVATE ROAD
	UNDEDICATED RIGHT OF WAY
	STREAM, RESERVOIR, or LAKE
	REFERENCE U.S.G.S. BENCHMARKS

NOTE:
1. LOTS WITH AN ADDRESS # INDICATE UPTSA SEWER ACCOUNTS.
2. LOTS DENOTED WITH A "ND" WITHIN A DISTRICT ARE NOT CONNECTED.

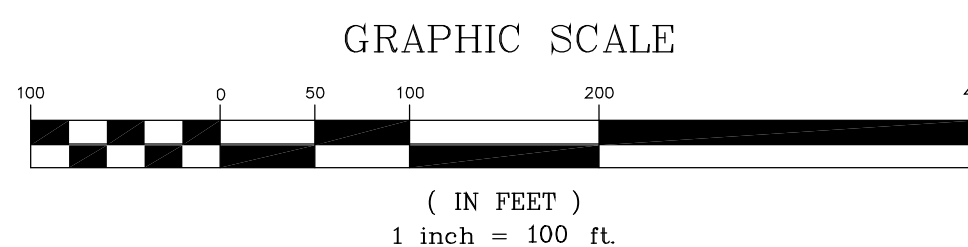

NOTE:
THE PURPOSE OF THIS MAP IS FOR GENERAL REFERENCE ONLY. ALL INFORMATION PROVIDED SHALL BE CONSIDERED APPROXIMATE IN NATURE. IT IS THE USER'S RESPONSIBILITY TO VERIFY ALL INFORMATION. ANY ERRORS, OMISSIONS OR DISCREPANCIES ARE TO BE REPORTED TO KELLY & CLOSE ENGINEERS.

DISTRICT 10A - TOFT WOODS (Distances)					
M.H. From:	M.H. To:	Distance (Ft.)	M.H. From:	M.H. To:	Distance (Ft.)
10-20	10-19	100.87	10-2	10-3	190.75
10-19	10-18	190.10	10-1	10-4	291.47
10-18	10-17	280.37	10-4	10-5	135.51
10-17	10-16	258.01	10-4	10-6	108.43
10-16	10-15	300.15	10-6	10-7	168.53
10-15	10-14	154.20	10-7	10-8	104.82
10-14	10-13	174.15	10-6	10-9	209.87
10-13	10-12	227.61	10-9	10-10	147.47
10-12	10-11	129.18	10-1	PS	67.09
10-11	10-1	107.57	FS 10-50	FS 10-46	712.16
10-1	10-2	212.54			

DISTRICT 10A - TOFT WOODS					
M.H. No.	RIM. ELEV.	INV. ELEV.	M.H. No.	RIM. ELEV.	INV. ELEV.
10-1	280.00	276.00	10-11	292.50	287.50
10-2	282.00	279.00	10-12	313.00	309.60
10-3	288.00	284.00	10-13	314.00	310.50
10-4	312.00	306.50	10-14	318.00	311.80
10-5	331.00	326.50	10-15	318.00	312.50
10-6	326.00	321.50	10-16	320.00	315.50
10-7	332.50	328.00	10-17	321.00	316.70
10-8	334.00	329.00	10-18	322.00	318.00
10-9	341.00	334.50	10-19	340.00	335.00
10-10	342.50	338.00	10-20	340.00	336.00

UPPER PROVIDENCE TOWNSHIP
SANITARY SEWER SYSTEM MAPS
UPPER PROVIDENCE TOWNSHIP
DELAWARE COUNTY, PENNSYLVANIA

SANITARY SEWER DISTRICT No. 10A
TOFT WOODS

SHEET
10A
of 12

K&C
KELLY & CLOSE ENGINEERS
CONSULTING ENGINEERS & SURVEYORS
1786 WILMINGTON PIKE/Suite 300
CHENOWETH, PENNSYLVANIA 19022
PH: 610-399-1000
FAX: 610-399-1001
WWW.KELLYANDCLOSE.COM

DATE	REV.	DESCRIPTION
8-14-1999	1	ORIGINAL PLANS - BEAR
10-14-14	2	REVISED TO ADD PUMP STA. - TOFT WOODS WAY
11-11-13	3	REVISED PER INSPECTOR COMMENTS AND LATEST AS BUILT PLANS
8-12-2013	4	REVISED PER INSPECTOR COMMENTS AND LATEST AS BUILT PLANS
8-12-2013	5	REVISED PER INSPECTOR COMMENTS AND LATEST AS BUILT PLANS
4-4-20	6	REVISED PER FIELD INSPECTOR AND AS BUILT PLANS
3-21-20	7	REVISED PER FIELD INSPECTOR AND AS BUILT PLANS