


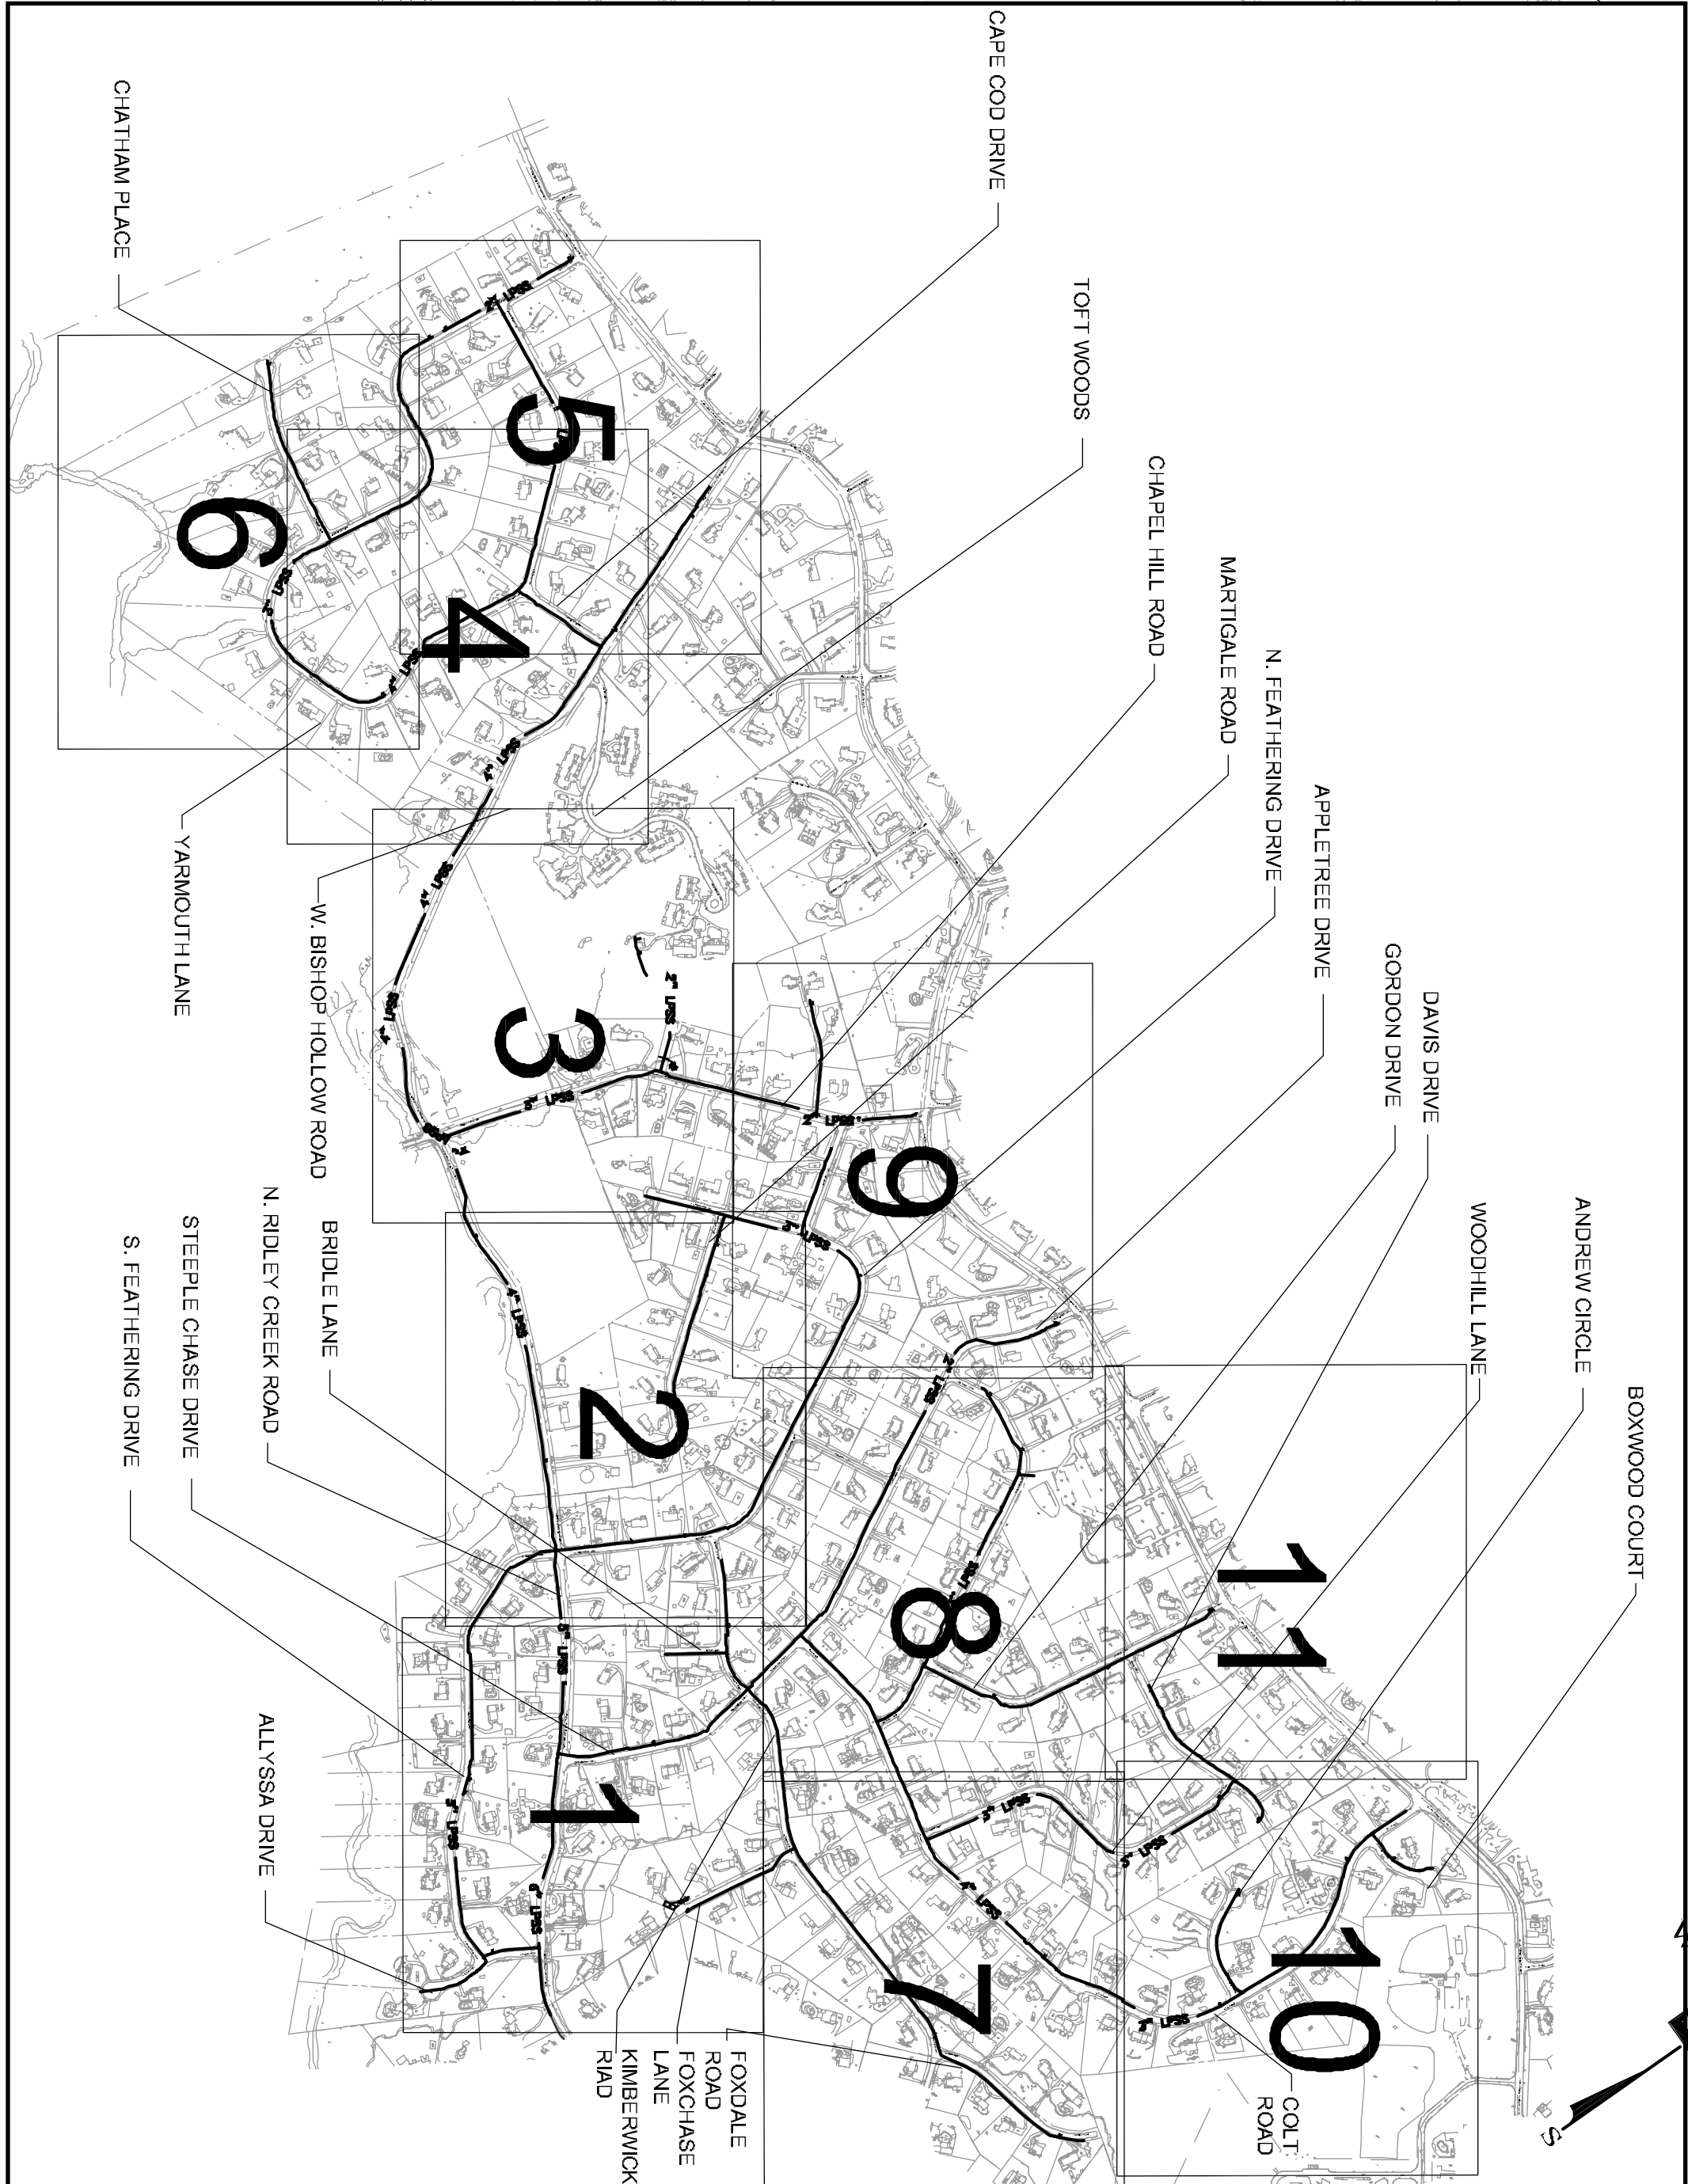

LEGEND

LPSS

END-LINE FLUSHING STATION

IN-LINE FLUSHING STATION

SERVICE VALVE

AIR RELEASE VALVE

AIR RELEASE VALVE & IN-LINE FLUSHING STATION

AR/FS

ARV

AR

GENERAL NOTE:

1. ALL LOW PRESSURE SANITARY SEWER (LPSS) LINES HAVE BEEN INSTALLED WITH A TRACER WIRE.

AS BUILT PLANS
RIDLEY CREEK LPSS

This document and all information and work product represented by and contained herein, is the sole and exclusive property of Jones C. Kelly & Associates, Inc., I/O Kelly & Close Engineers. The information contained herein is loaned only for limited use by the intended recipient and no license, permission or authority is extended, directly or implied, to any party without express written permission of Jones C. Kelly & Associates, Inc.

Copyright, 2008, Jones C. Kelly & Associates, Inc.
All rights reserved.

UPPER PROVIDENCE TOWNSHIP
SANITARY SEWER EXTENSION
SEWER SERVICE AREAS TWO - FOUR
UPPER PROVIDENCE TOWNSHIP
DELAWARE COUNTY, PENNSYLVANIA

Scale:	March 5, 2012				
Scale:	1"=60'				
Drawn by:	J.R.K.				
Checked by:	K.M.M.				
Dwg. name:	F-As Bults.dwg	2	10-24-13	COMPLETION OF AS-BUILTS & FORMATING FOR OPERATING MAPS	LWF
Project no.:	UPTSA-220	1	08-16-13	REV. PER REVIEW BY R. SPELMAN DTD. 07-31-13	LWF
REV:	DATE			DESCRIPTION	BY

K&C

KELLY & CLOSE ENGINEERS
CONSULTING ENGINEERS & SURVEYORS

The Summit at Brandywine
1706 Wilmington Pike/Suite 300
Glen Mills, Pennsylvania 19342
610.358.9363 Fax 610.358.9376

ORIGINAL PLANS BEAR
REGISTRATION SEAL IN RED INK