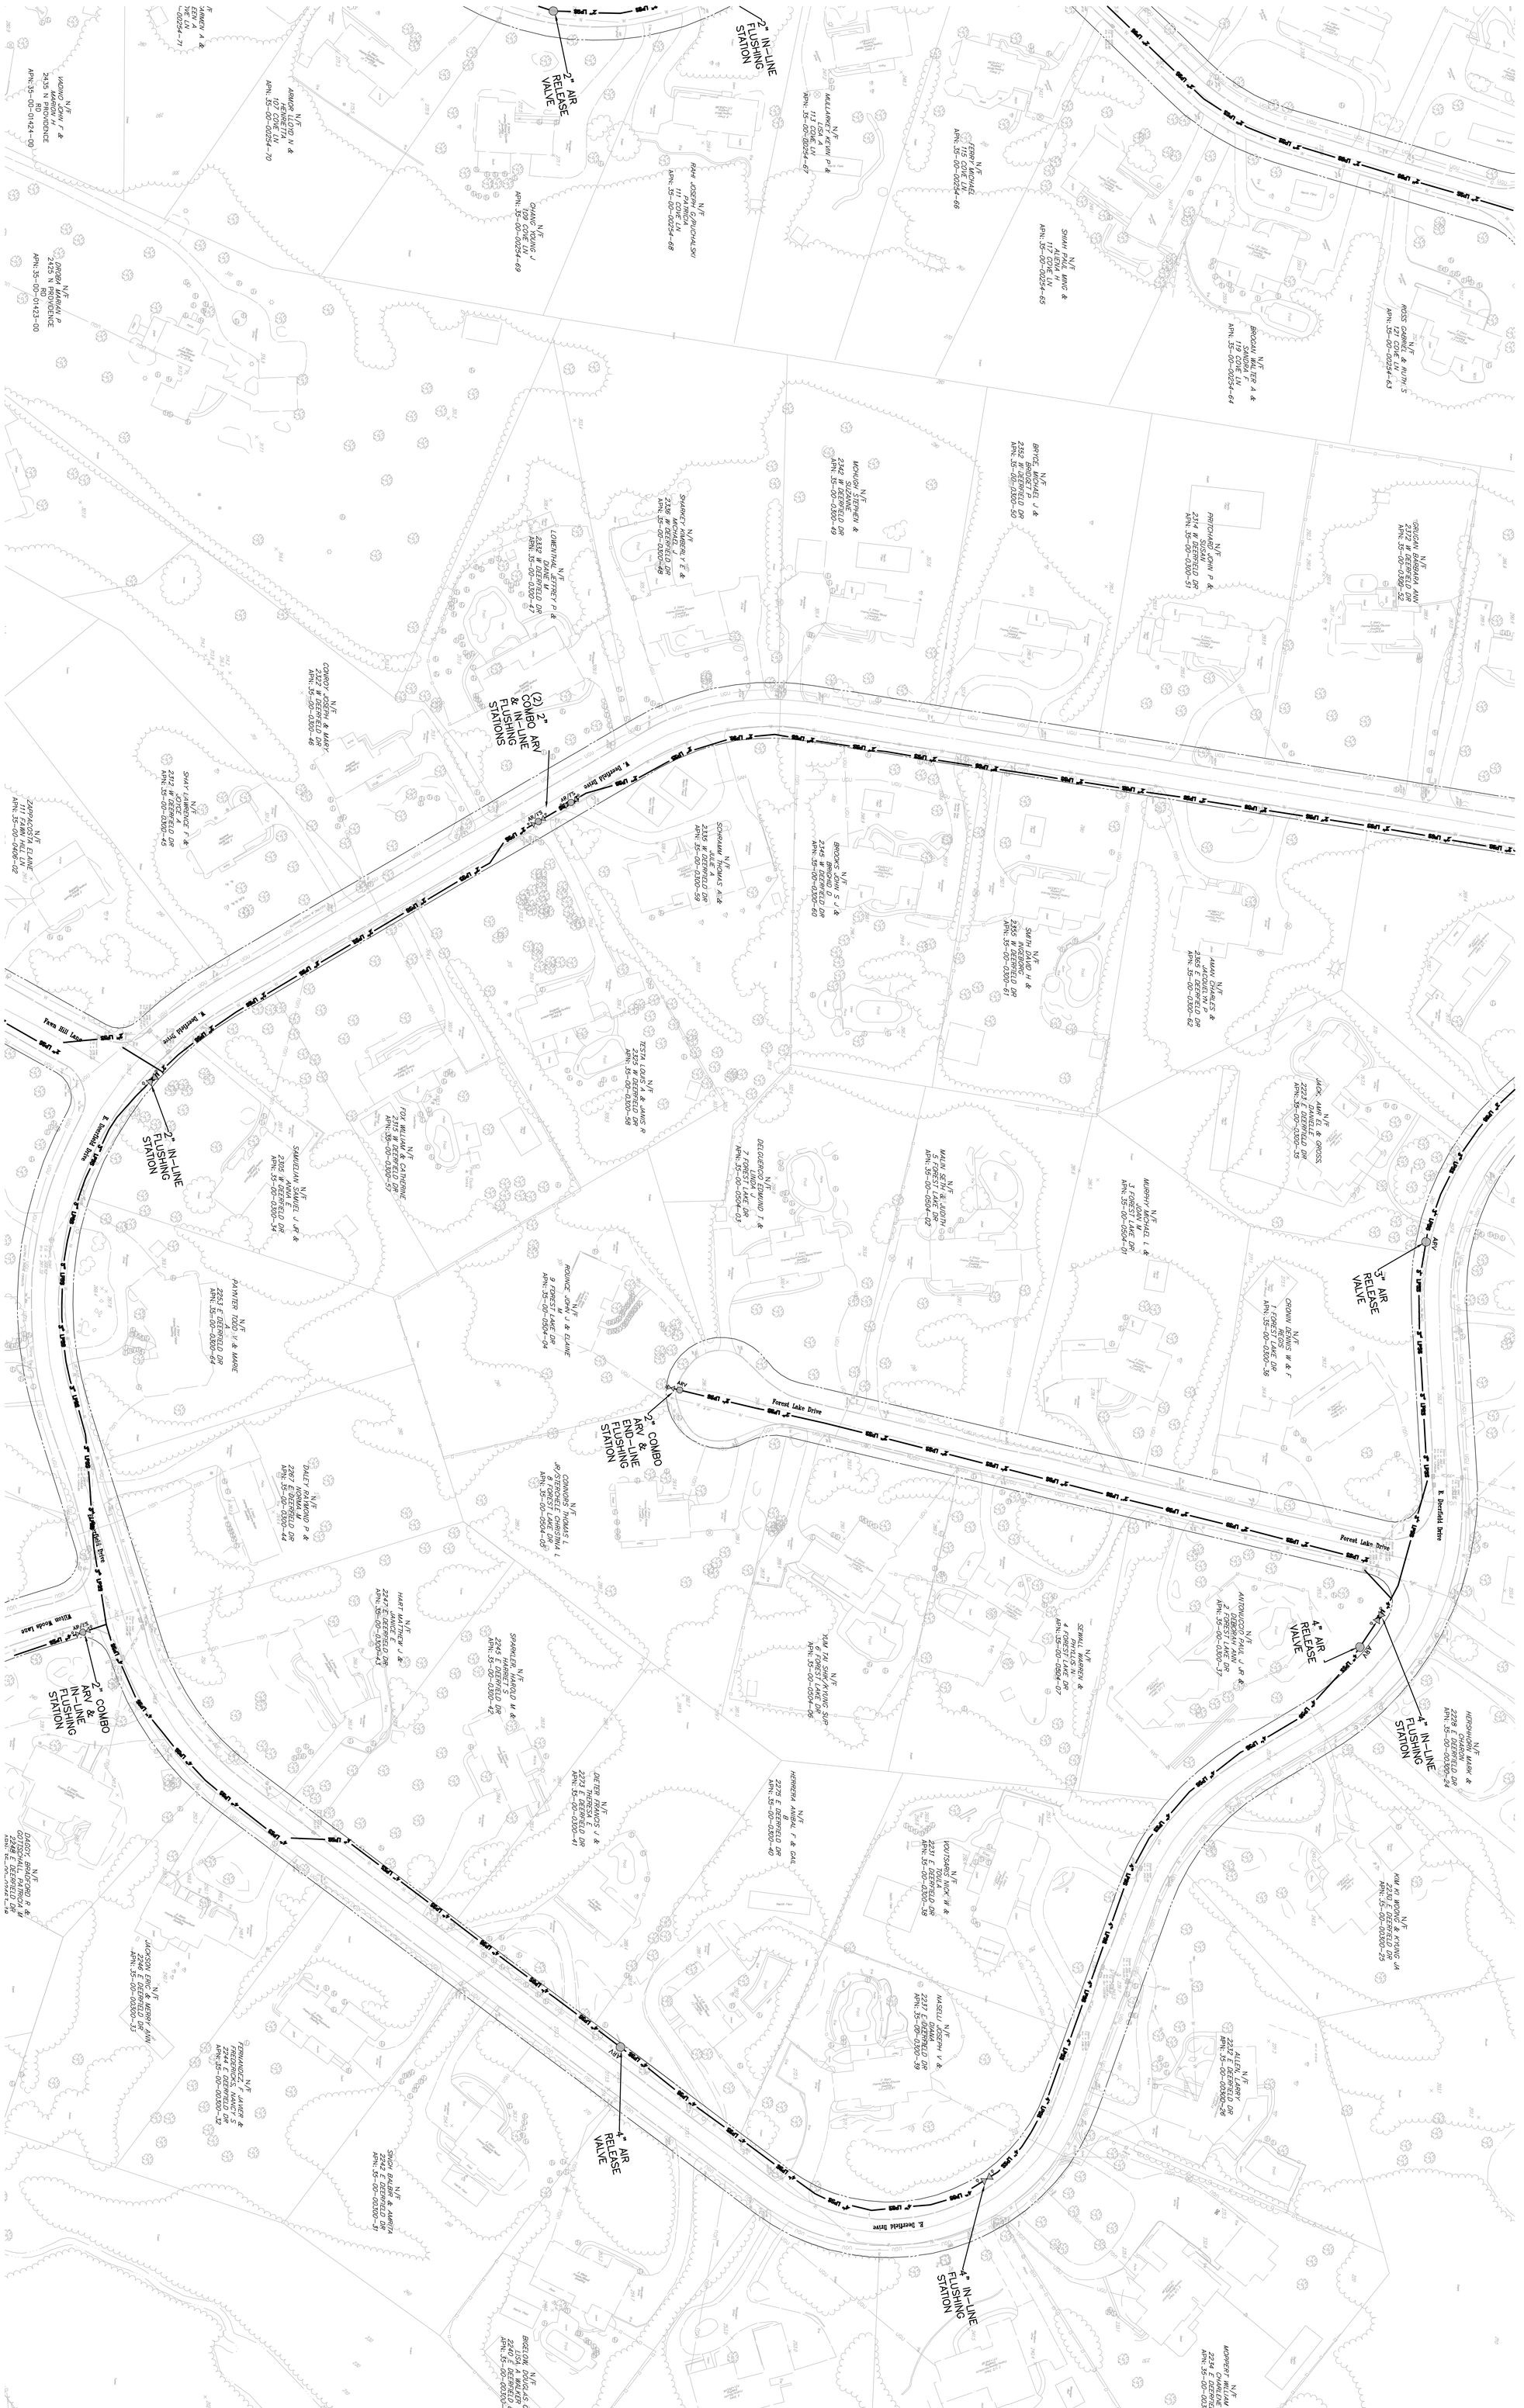

LEGEND

LPSS	LOW PRESSURE SANITARY SEWER
	END-LINE FLUSHING STATION
	IN-LINE FLUSHING STATION
SV	SERVICE VALVE
ARV	AIR RELEASE VALVE
AR/FS	AIR RELEASE VALVE & IN-LINE FLUSHING STATION

GENERAL NOTE:

1. ALL LOW PRESSURE SANITARY SEWER (LPSS) LINES HAVE BEEN INSTALLED WITH A TRACER WIRE.

SHEET 8 of 16

AS BUILT PLANS
CRUM CREEK LPSS – NORTH

This document and all information and work product represented by and contained herein, is the sole and exclusive property of James C. Kelly & Associates, Inc., t/a Kelly & Close Engineers. The information contained herein is licensed only for limited use by the intended recipient, and no license, permission or authority is extended, directly or implied, to any party without express written permission of James C. Kelly & Associates, Inc.

Copyright, 2014, James C. Kelly & Associates, Inc.
All rights reserved

UPPER PROVIDENCE TOWNSHIP
SANITARY SEWER EXTENSION
SEWER SERVICE AREAS FIVE, SIX AND SEVEN
UPPER PROVIDENCE TOWNSHIP
DELAWARE COUNTY, PENNSYLVANIA

date:	Feb. 28, 2014
scale:	1" = 60'
drawn by:	D.S.
checked by:	J.P.K.
dwg. name:	F-AsBuilts.dwg
project no.:	UPTSA-220

REV.	DATE	DESCRIPTION	BY
1	01-09-15	ADDITIONAL AS-BUILT INFORMATION PER D SPILLMAN	LWF

KELLY & CLOSE ENGINEERS
CONSULTING ENGINEERS & SURVEYORS
The Summit at Brandywine
1786 Wilmington Pike/Suite 300
Glen Mills, Pennsylvania 19342
610.358.9363 fax 610.358.9376

ORIGINAL PLANS BEAR A REGISTRATION SEAL IN RED INK.